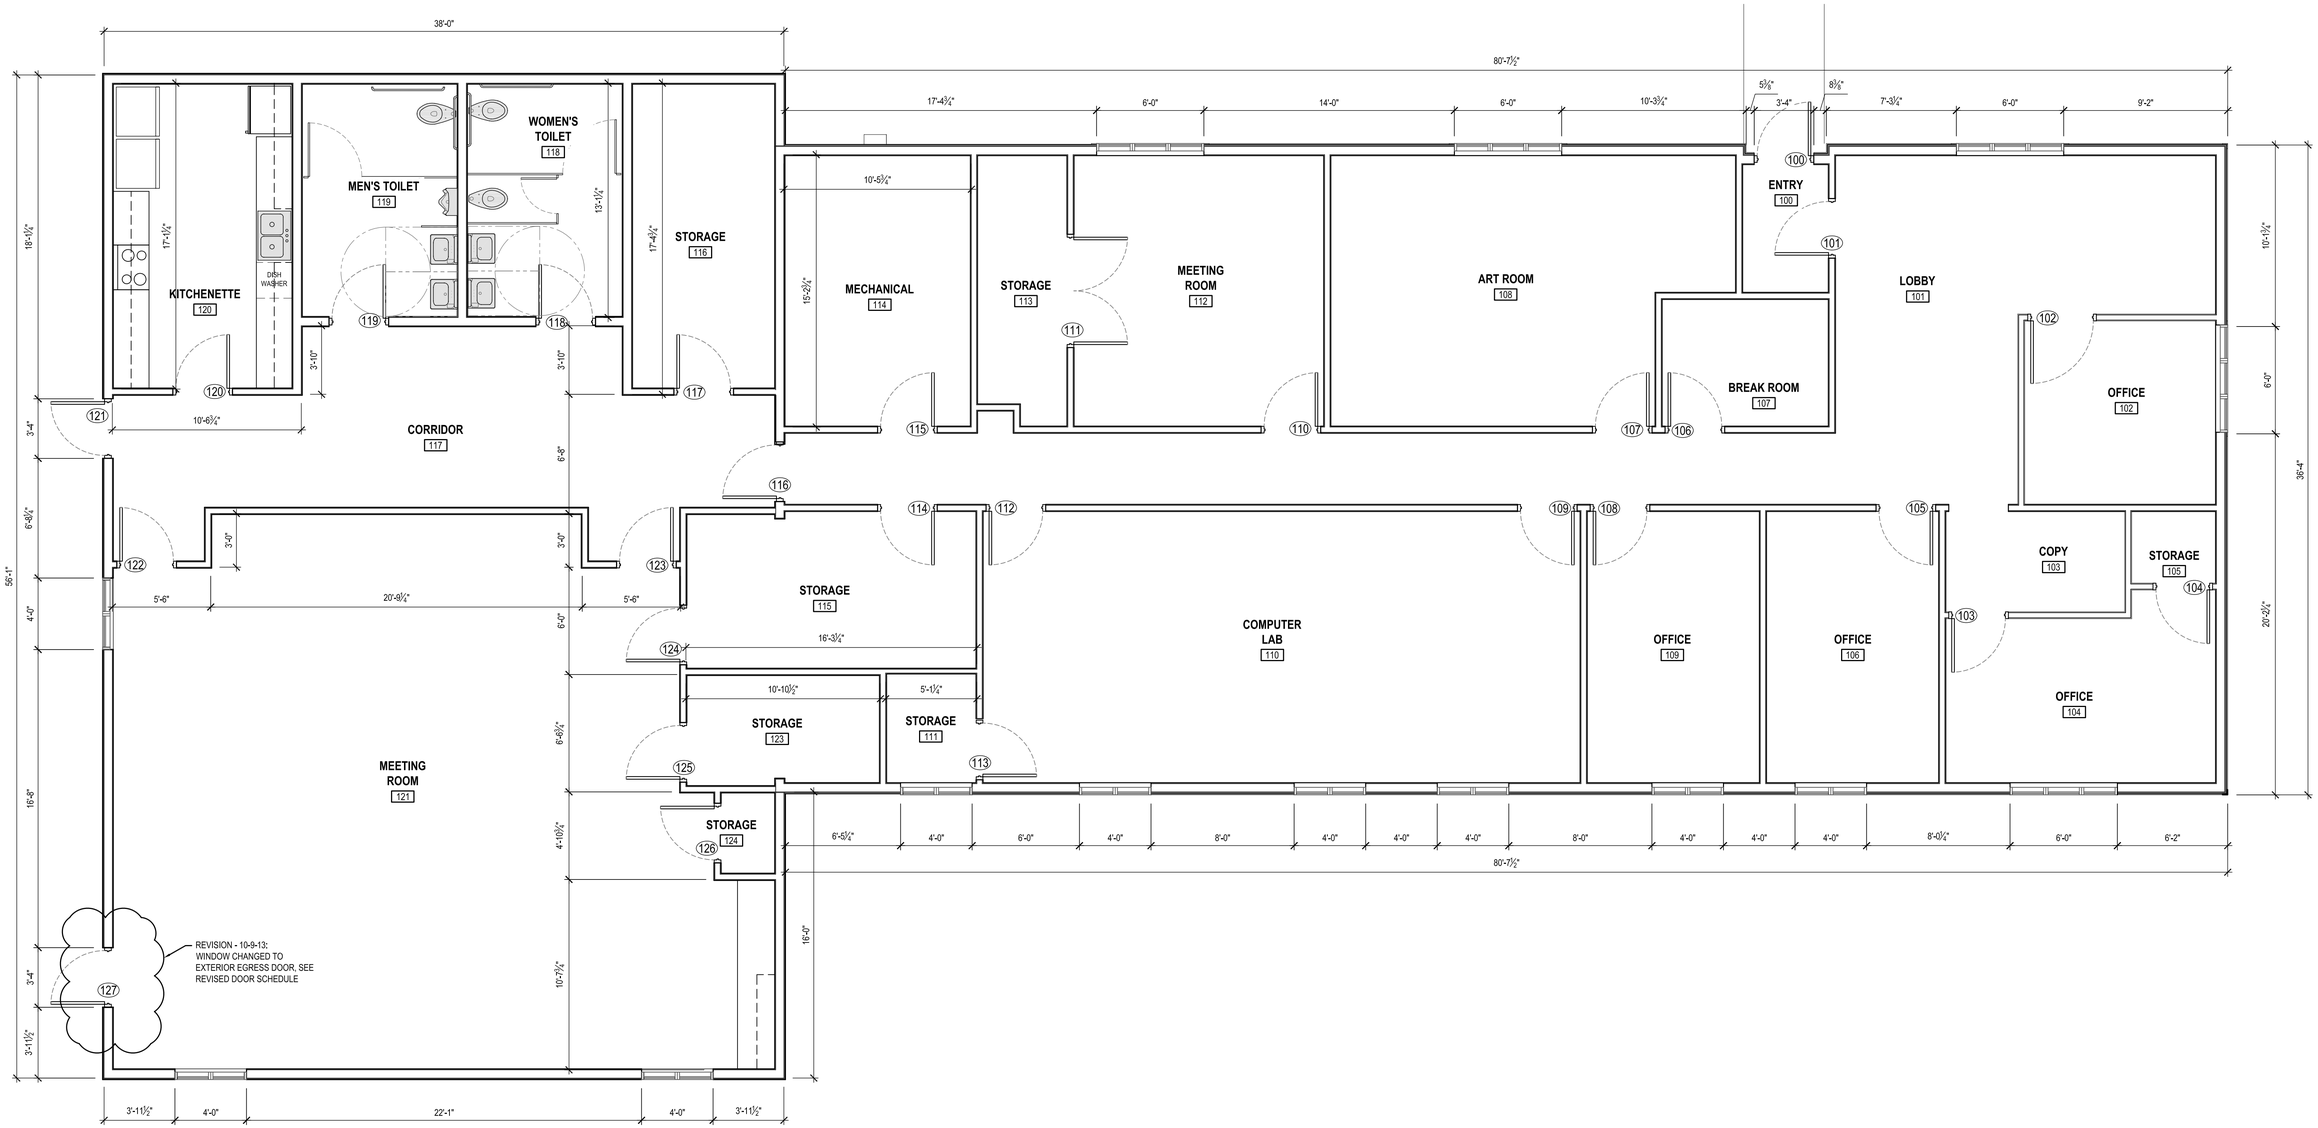

FLOOR PLAN

SCALE: 1/4" = 1'-0"

Connell Architecture, P.C.
2909 Falling Leaf Lane Suite K
Columbia, Missouri 65201
573-875-2455 Fax 573-875-2456
connell.arch@centurytel.net

DO NOT SCALE THIS DRAWING SOME DEVIATION FROM SCALE MAY OCCUR FROM REPRODUCTION. DRAWINGS ARE THE PROPERTY OF CONNELL ARCHITECTURE, P.C. & MAY NOT BE COPIED OR USED IN WHOLE OR PART WITHOUT THE WRITTEN CONSENT OF CONNELL ARCHITECTURE, P.C.

CHECKED BY: BDC

DRAWN BY: EPW

ISSUE

ID	DESCRIPTION	DATE
1	PERMIT SET	7-15-2013
2	ADDITION PERMIT	9-8-13
3	REVIEW COMMENTS	10-9-13

PROJECT

WATERS-MOSS ACTIVITY CENTER
ADDITION & ALTERATIONS

1907 HILLCREST DRIVE
COLUMBIA, MISSOURI 65201

PROJECT NO. 13-009

SHEET TITLE FLOOR PLAN

SHEET NUMBER A-2