


LONGVIEW PARK

4980 GILLESPIE BRIDGE ROAD

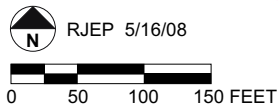

KEY	
	CITY STREET
	GRAVEL TRAIL
	PARK PROPERTY LINE

PARK AMENITIES	
11.8 ACRES	1 - PLAYFIELD (UNLIT)
1 - NON-RESERVABLE SHELTER	1 - BASKETBALL COURT (HALF)
4 - PICNIC TABLES IN SHELTER	FITNESS COURSE - 0.5 MILE
NO LIGHTS	PLAYGROUND
NO ELECTRICITY	1- FISHING POND
NO RESTROOMS	
SINGLE GRILL	